


DATE: 1/11/05, TIME: 3:31 P.M., DRAWING NO.: 9719351, SHEET NO.: 4 OF 6, PROJECT NO.: 9719351, CLIENT: HERRIMAN CITY, 1464 S. JUPITER CREST ROAD, HERRIMAN, UT 84043, ENGINEER: NOLTE BEYOND ENGINEERING, 2217 SOUTH STATE STREET, SUITE 300, BOULDER, CO 80501, PHONE: (303) 440-1100, FAX: (303) 440-1101, WWW.NOLTE.COM

CURVE TABLE with columns: CURVE, DELTA, RADIUS, LENGTH, TANGENT, CH. BEARING, CHORD. Contains data for curves C1 through C133.


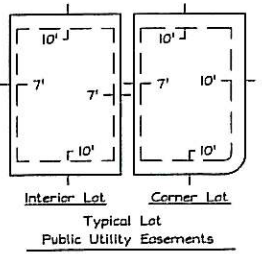


LINE TABLE with columns: LINE, BEARING, DISTANCE. Contains data for lines L1 through L10.

CURVE TABLE with columns: CURVE, DELTA, RADIUS, LENGTH, TANGENT, CH. BEARING, CHORD. Contains data for curves C134 through C204.

ROSECREST PLAT O BOOK 2004P PAGE 228

ROSECREST PLAT Q BOOK 2005P PAGE 100

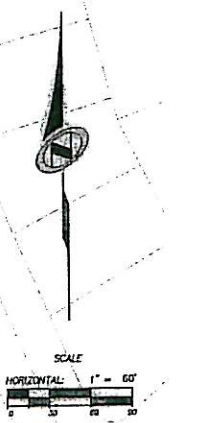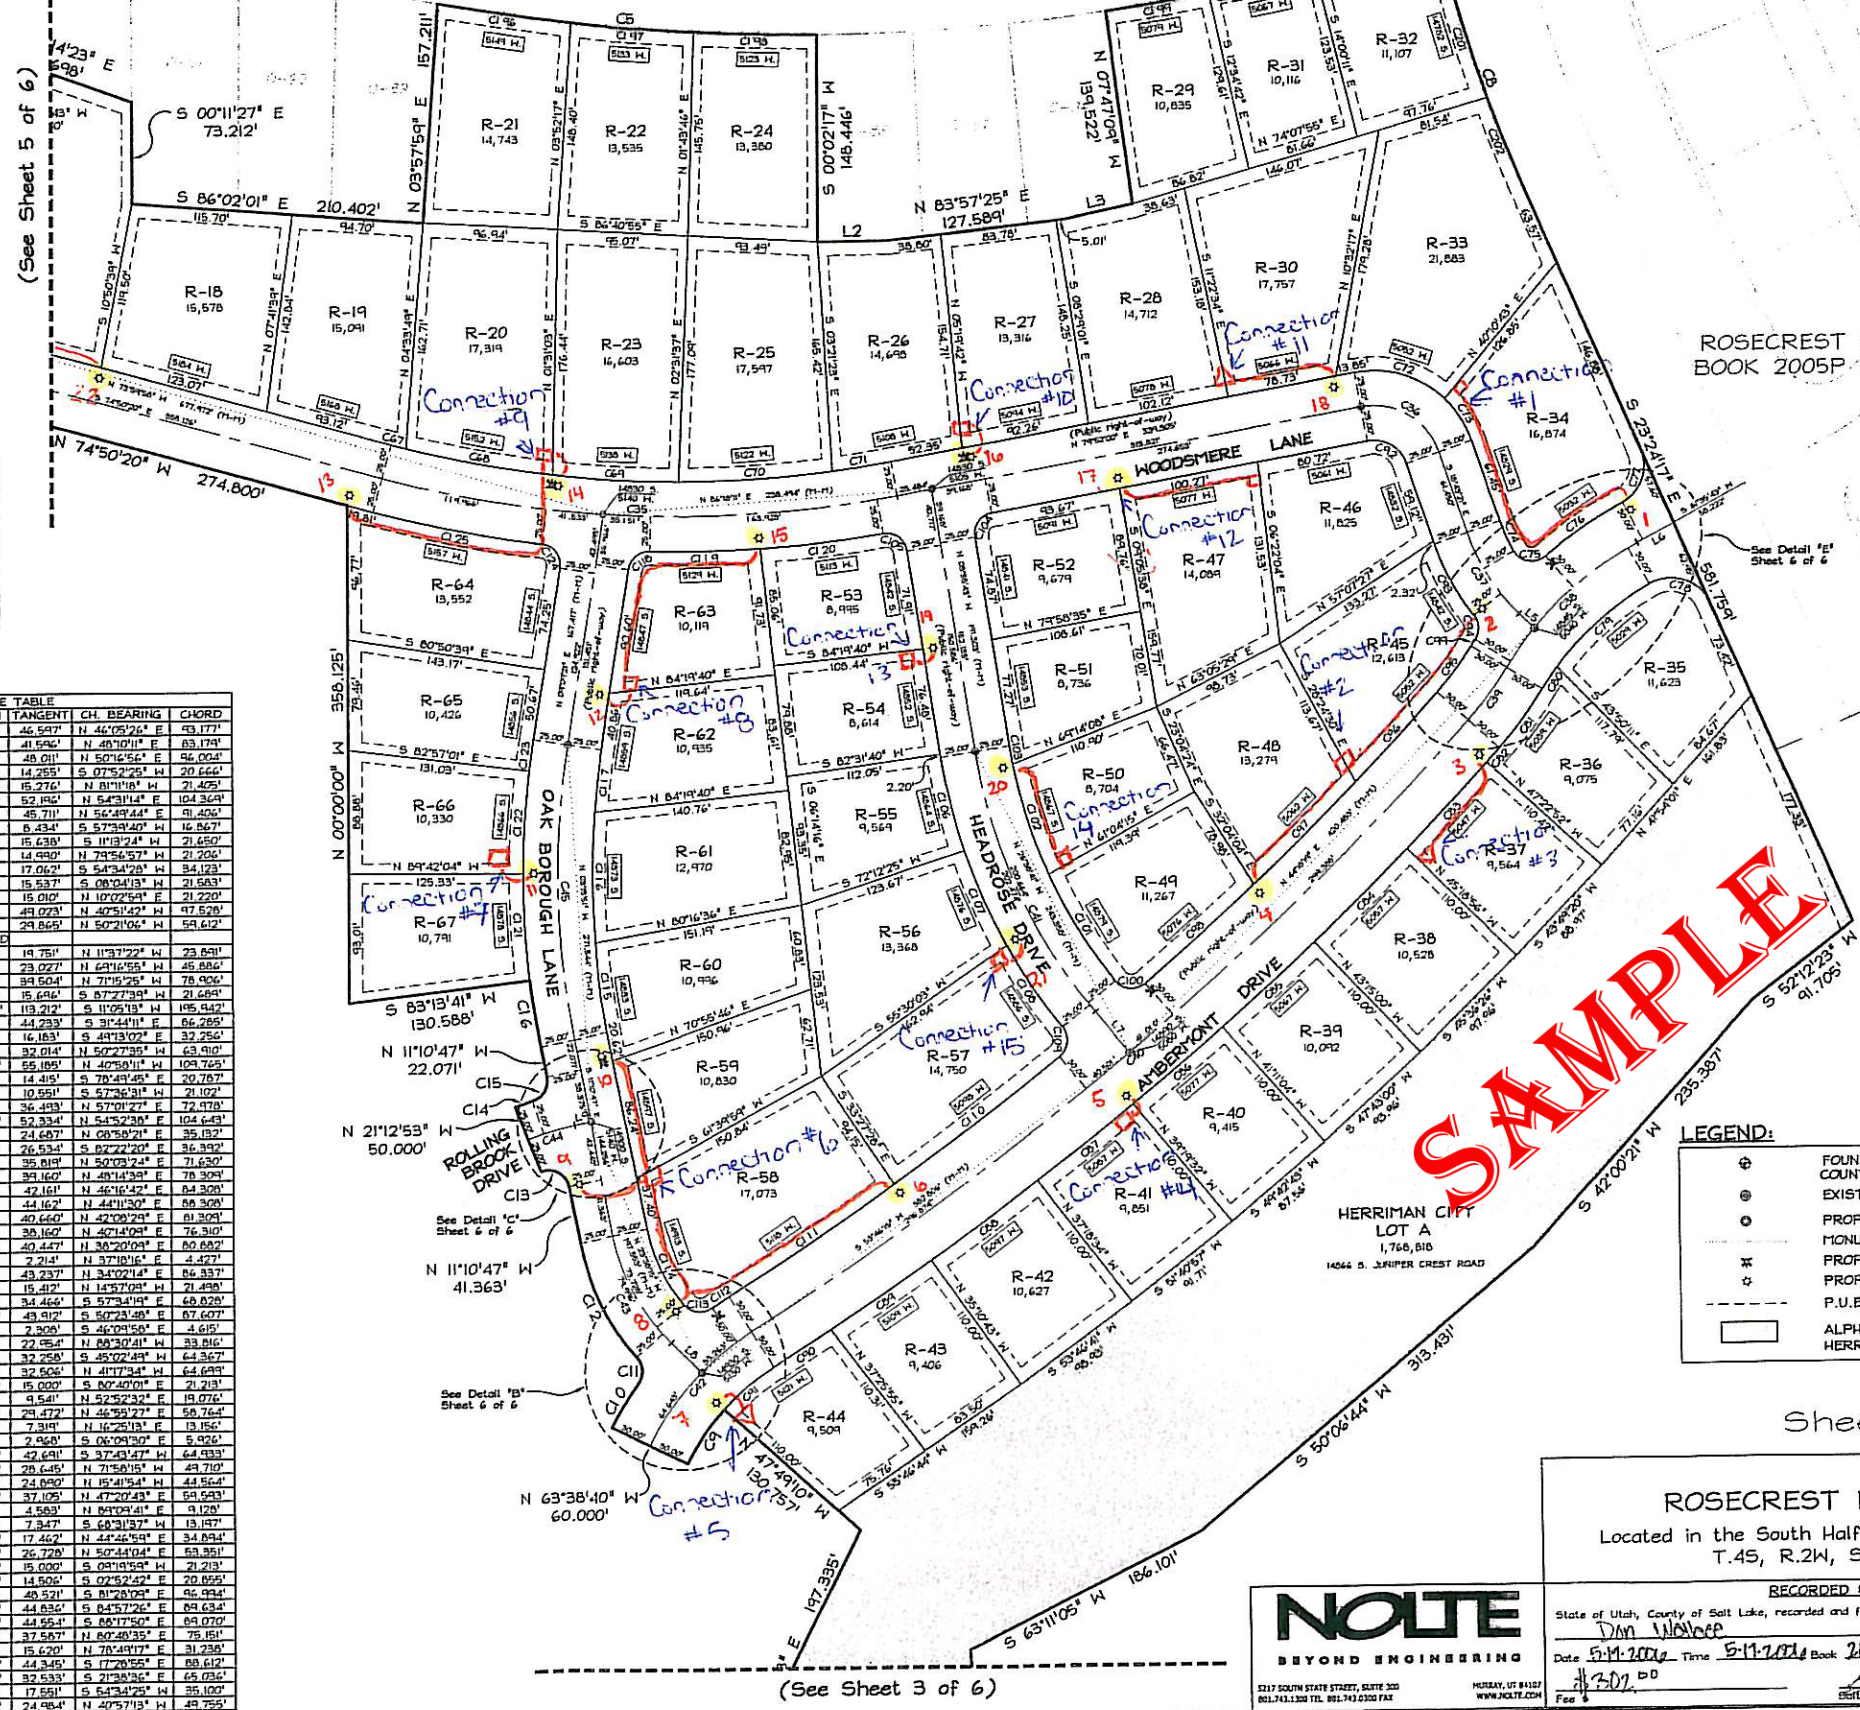

SAMPLE (Large red watermark text)

- LEGEND: Symbols for FOUND SALT LAKE COUNTY MONUMENT, EXISTING STREET MONUMENT, PROPOSED STREET MONUMENT, MONUMENT TO MONUMENT, PROPOSED FIRE HYDRANT, PROPOSED STREET LIGHT, P.U.E. & DRAINAGE EASEMENT, ALPHA LOT DEDICATED TO HERRIMAN CITY.

ROSECREST PLAT R Located in the South Half of Section 12, T.4S, R.2W, S1/4M

RECORDED # 9719351

NOLTE BEYOND ENGINEERING logo and address: 2217 SOUTH STATE STREET, SUITE 300, BOULDER, CO 80501, PHONE: (303) 440-1100, FAX: (303) 440-1101, WWW.NOLTE.COM

State of Utah, County of Salt Lake, recorded and filed at the request of: Date: 5/11/2005, Time: 5:11:22 PM, Book: 2004P, Page: 143, 144, 145, 999, 1000.

(See Sheet 3 of 6)

Sheet 4 of 6